

**MFS CONSULTING, LLC**  
MFS CONSULTING, LLC  
103 C/ ISABEL ANDREU DE AGUILAR,  
SUITE 3, SAN JUAN, PR 00918  
T: 787.898.7436  
F: 866.517.7413  
www.MFSengineers.com  
www.MFSolar.com

JOSE A. FUERTES  
PROF. ENGINEER PR. LIC. NO. 19816  
EXPIRES: 10/2024

CONSULTANTS:

PREPARED FOR:  
STATE HISTORIC PRESERVATION OFFICE (SHPO)

DRAWING TITLE:  
  
**ELEVATIONS**

PROJECT NAME:  
**ANTIGUO CUARTEL DE BALLAJÁ**  
RESTORATION PROJECT  
(FEMA #63264 SHPO-428 PROJECT)  
  
**AS-BUILT DRAWINGS**  
  
CALLE NORZAGARAY,  
ESQUINA BENEFICENCIA  
SAN JUAN, PUERTO RICO, 00901

| Submissions |       |      |
|-------------|-------|------|
| NO.         | ISSUE | DATE |
|             |       |      |
|             |       |      |
|              |                |
|--------------|----------------|
| PROJECT NO.: | 1920029        |
| DATE:        | 24/FEBRUARY/23 |
| SCALE:       | AS_NOTED       |
| DRAWN BY:    | BBM            |
| CHECKED BY:  | JAF            |

DRAWING NUMBER:  
  
**AB-9**




|        |    |     |    |
|--------|----|-----|----|
| SHEET: | 10 | OF: | 13 |
|--------|----|-----|----|






WEST ELEVATION

1" = 5' 10' 20'

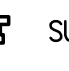**LIGHTING FIXTURE LEGEND:**


   SURFACE MOUNTED LIGHTING FIXTURE

  SUSPENDED MOUNTED LIGHTING FIXTURE

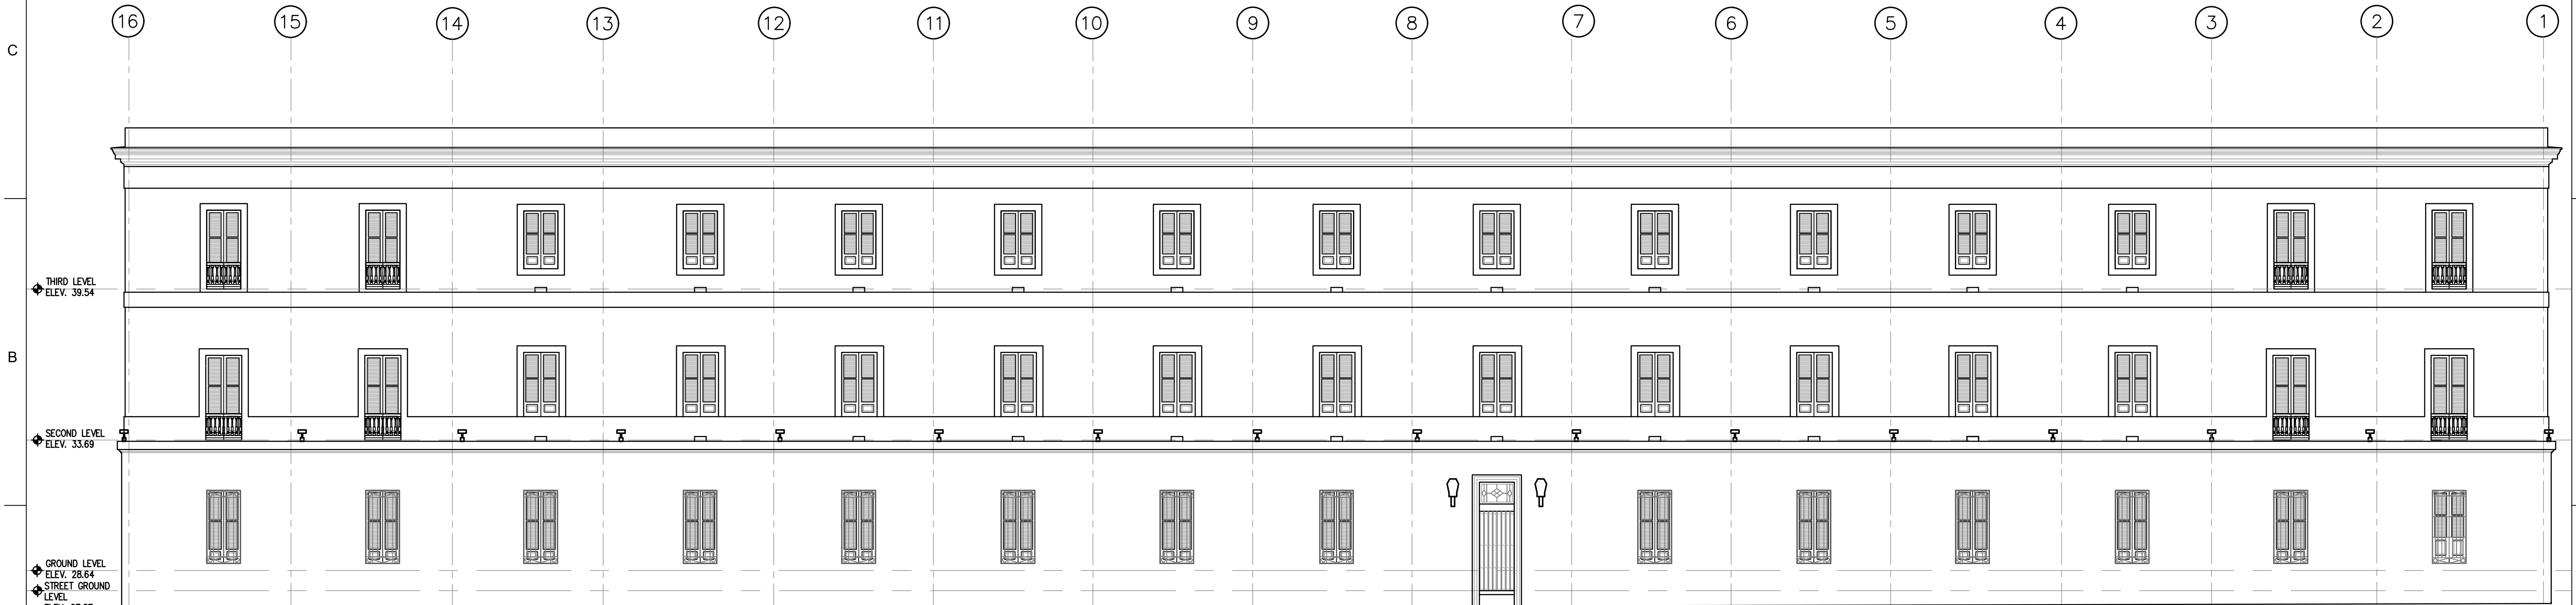


NORTH ELEVATION

1" = 5' 10' 20'

**CONSULTING, LLC**

MFS CONSULTING, LLC  
103 C/ ISABEL ANDREU DE AGUILAR,  
SUITE 3, SAN JUAN, PR 00918  
T: 787.898.7436  
F: 866.517.7413  
www.MFSengineers.com  
www.MFSolar.com



JOSE A. FUERTES  
INGENIERO  
LICENCIADO  
LIC. 19816  
PUERTO-RICO

JOSE A. FUERTES  
PROF. ENGINEER PR. LIC. NO. 19816  
EXPIRES: 10/2024

CONSULTANTS:

PREPARED FOR:  
STATE HISTORIC PRESERVATION OFFICE (SHPO)

DRAWING TITLE:  
**ELEVATIONS**

PROJECT NAME:  
**ANTIGUO CUARTEL DE BALLAJÁ**  
RESTORATION PROJECT  
(FEMA #63264 SHPO-428 PROJECT)  
**AS-BUILT DRAWINGS**  
CALLE NORZAGARAY,  
ESQUINA BENEFICIENCIA  
SAN JUAN, PUERTO RICO, 00901

| Submissions |       |      |
|-------------|-------|------|
| NO.         | ISSUE | DATE |
|             |       |      |
|             |       |      |
|              |                |
|--------------|----------------|
| PROJECT NO.: | 1920029        |
| DATE:        | 24/FEBRUARY/23 |
| SCALE:       | AS_NOTED       |
| DRAWN BY:    | BBM            |
| CHECKED BY:  | JAF            |

DRAWING NUMBER:  
**AB-10**

|        |    |     |    |
|--------|----|-----|----|
| SHEET: | 11 | OF: | 13 |
|--------|----|-----|----|